

NOTES:

- ALL STRUCTURAL ALUMINUM IS ALLOY 6061-T6, MILL FINISH.
- ALL JOINTS ARE FULLY WELDED UNLESS NOTED OTHERWISE. FILLER METAL TO BE 5356 SERIES WIRE.
- ALL HARDWARE IS STAINLESS STEEL, SERIES 304.
- ALL WOOD FENDERS TO BE S.Y.P. #1 PRESSURE TREATED TO 0.40 PCF ACQ MINIMUM OR EQUAL. ISOLATE WOOD FROM ALUMINUM WITH BITUMINOUS PAINT, CARBOLINE BIT 50 OR EQUAL.
- FLOATING DOCKS DESIGNED FOR AN 18"± UNLOADED FREEBOARD AND AN 8"± LOADED FREEBOARD UNDER A 40 PSF LIVE LOAD.
- GANGWAYS DESIGNED FOR 50 PSF LIVE LOAD, L/180 DEFLECTION.
- HAND RAILING DESIGNED FOR 50 PLF LIVE LOAD OR 200# POINT LOAD.
- PILE GUIDE LOCATIONS ARE SUGGESTED FOR COMPATIBILITY WITH DOCK LAYOUT ONLY. PILE TYPE, SIZE, QTY, AND DESIGN BY OTHERS.
- DOCK DIMENSIONS SHOWN ARE NOMINAL FROM ALUMINUM TO ALUMINUM FRAME. FINAL FINISHED DIMENSIONS WILL VARY ACCORDING TO INSTALLED FENDERS & BUMPERS.

GatorDock
Marine Access Solutions

2880 MELLONVILLE AVE, SANFORD, FL 32773
800/256-8857 407/323-0190

THE INFORMATION CONTAINED IN THIS DRAWING IS THE SOLE PROPERTY OF GATOR DOCK & MARINE, LLC. ANY REPRODUCTION IN PART OR AS A WHOLE WITHOUT THE WRITTEN PERMISSION OF GATOR DOCK & MARINE, LLC IS PROHIBITED.

RECORD OF REVISIONS		
No.	DATE	DESCRIPTION:
0	7/20/18	DRAFT
1	7/26/18	DRAFT
2	7/30/18	AS BUILT

PROJECT NAME:
WOODLAND WHARF

CUSTOMER NAME:
DELAWARE DNREC

CUSTOMER ADDRESS:
**89 KINGS HIGHWAY
DOVER, DE 19901**

PROJECT LOCATION:
**5115 WOODLAND FERRY RD
SEAFORD, DE 19973**

CMI ORDER NO.:
N/A

CUST. PO NO.:
N/A

	NAME	DATE
DRAWN BY:	VRP	7/30/18
CHECKED BY:	JN	7/24/18


DRAWING NO.:
S-101
OVERALL PLAN

SHEET: **1 of 8**

Physical properties are defined by ASTM testing standards, The Aluminum Association Design Manual, and/or standard engineering practice. The values shown are nominal and may vary. The information found in this document is believed to be true and accurate. No warranties of any kind are made as to the suitability of any CMI product for particular applications or the results obtained there from. ShoreGuard, C-Loc, TimberGuard, GeoGuard, Dura Dock, Shore-All, and Gator Gates are registered trademarks of CMI Limited Co. ArmorWare, Ultra Composite, GatorDocks, and CMI Waterfront Solutions are trademarks of CMI Limited Co. United States and International numbers 5,145,287; 5,881,508; 6,000,883; 6,033,155; 6,053,666; D420,154; 4,674,921; 4,690,588; 5,292,208; 6,575,667; 7,059,807; 7,056,066; 7,025,539; 1,245,061; c Other patents pending. 2017 CMI Limited Co. All Rights Reserved.


CMI LIMITED CO.
1165 NORTHCHASE PARKWAY SE
SUITE 300 - MARIETTA, GA 30067
PHONE: 770-933-8166

NOT FOR CONSTRUCTION

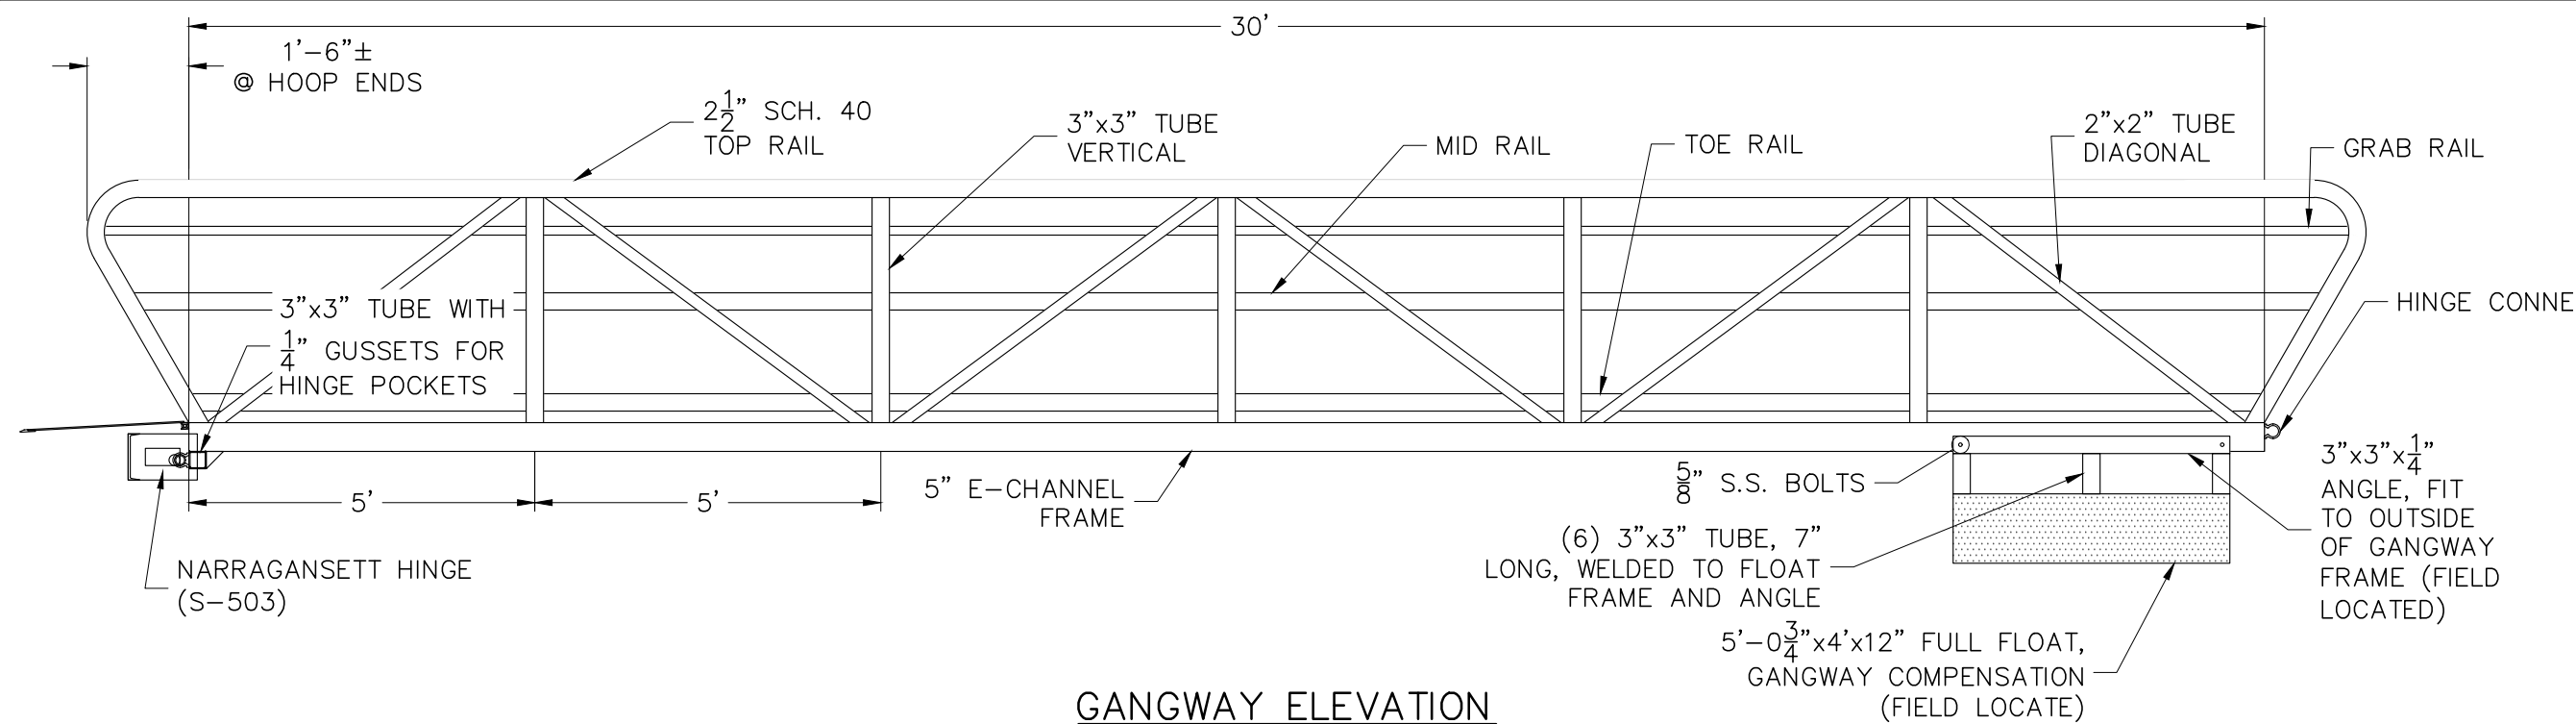

GANGWAY ELEVATION

SCALE: 3/8"=1'-0"

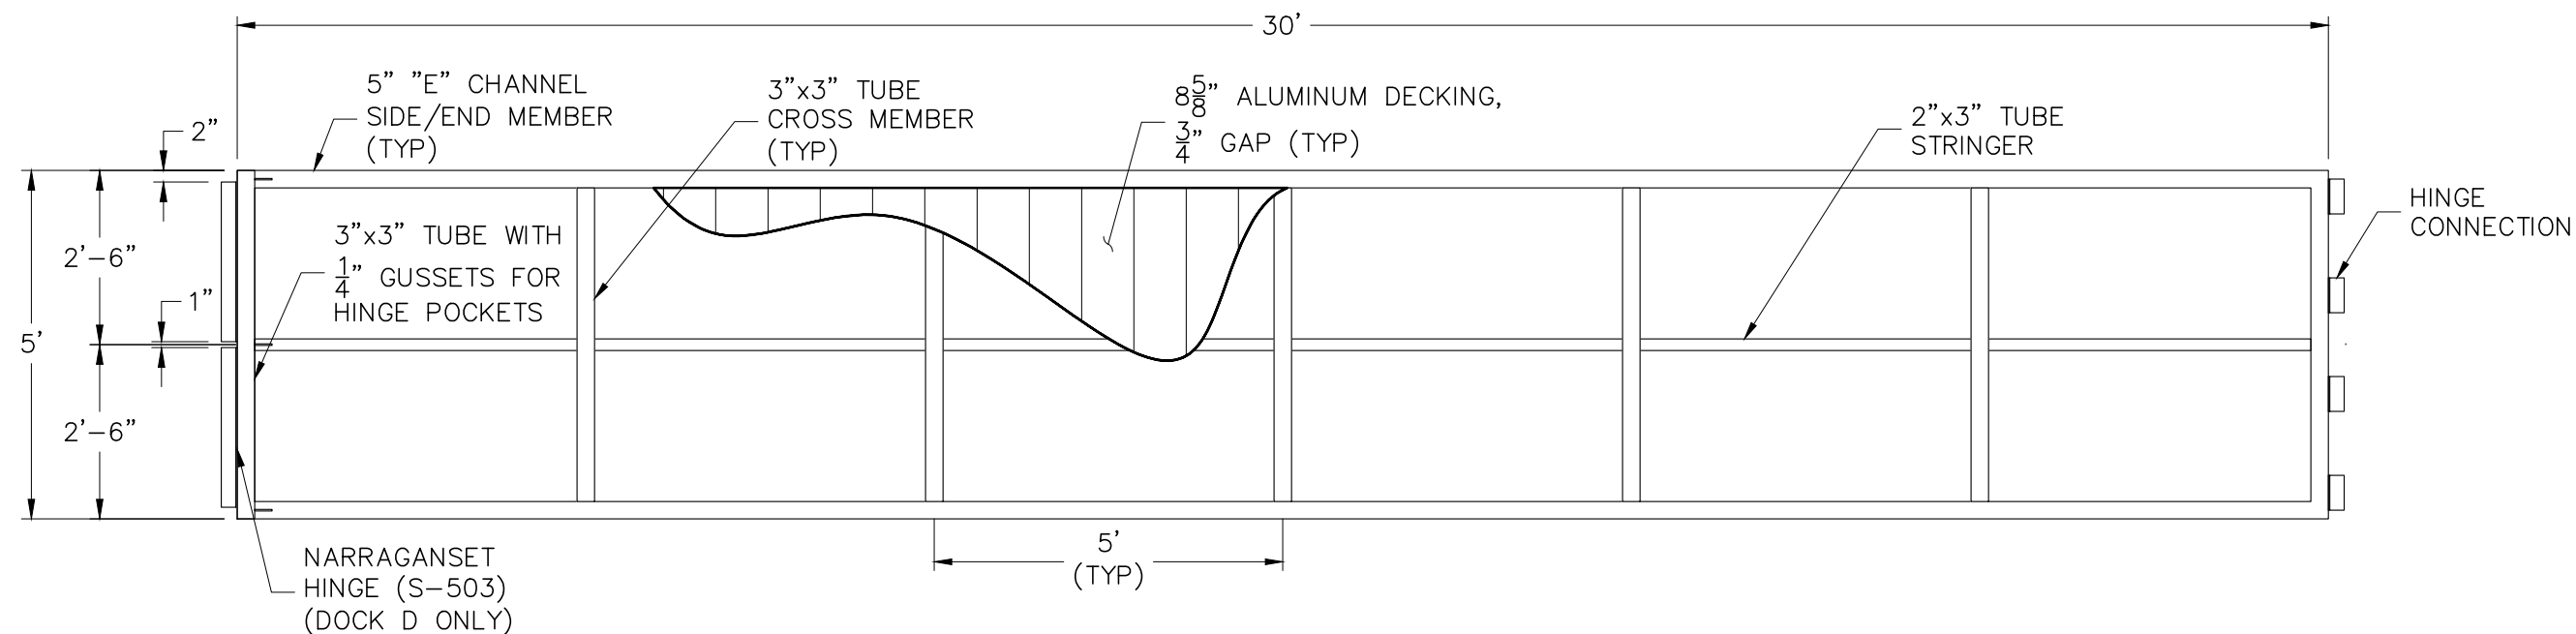

GANGWAY PLAN

SCALE: 3/8"=1'-0"

WEIGHT ≈ 1,200 lbs



2880 MELLONVILLE AVE, SANFORD, FL 32773
800/256-8857 407/323-0190

THE INFORMATION CONTAINED IN THIS DRAWING IS THE SOLE PROPERTY OF GATOR DOCK & MARINE, LLC. ANY REPRODUCTION IN PART OR AS A WHOLE WITHOUT THE WRITTEN PERMISSION OF GATOR DOCK & MARINE, LLC IS PROHIBITED.

RECORD OF REVISIONS

No.	DATE	DESCRIPTION:
0	7/20/18	DRAFT
1	7/26/18	DRAFT
2	7/30/18	AS BUILT

PROJECT NAME:

WOODLAND WHARF

CUSTOMER NAME:

DELAWARE DNREC

CUSTOMER ADDRESS:

**89 KINGS HIGHWAY
DOVER, DE 19901**

PROJECT LOCATION:

**5115 WOODLAND FERRY RD
SEAFORD, DE 19973**

CMI ORDER NO.:

N/A

CUST. PO NO.:

N/A

	NAME	DATE
--	------	------

DRAWN BY:	VRP	7/30/18
-----------	-----	---------

CHECKED BY:	JN	7/24/18
-------------	----	---------

DRAWING NO.:

S-301


GANGWAY PLAN

SHEET: **2 of 8**

Physical properties are defined by ASTM testing standards. The Aluminum Association Design Manual, and/or standard engineering practice. The values shown are nominal and may vary. The information found in this document is believed to be true and accurate. No warranties of any kind are made as to the suitability of any CMI product for particular applications or the results obtained there from. ShoreGuard, C-Lox, TimberGuard, GeoGuard, Dura Dock, Shore-All, and Gator Gates are registered trademarks of CMI Limited Co. ArmorWare, Ultra Composite, GatorDocks, and CMI Waterfront Solutions are trademarks of CMI Limited Co. United States and International numbers 5,145,287; 5,881,508; 6,000,883; 6,033,155; 6,053,666; D420,154; 4,674,921; 4,690,588; 5,292,208; 6,575,667; 7,059,807; 7,056,066; 7,025,539; 1,245,061; c Other patents pending. 2017 CMI Limited Co. All Rights Reserved.

CMI LIMITED CO.
1165 NORTHCHASE PARKWAY SE
SUITE 300 - MARIETTA, GA 30067
PHONE: 770-933-8166


NOT FOR CONSTRUCTION

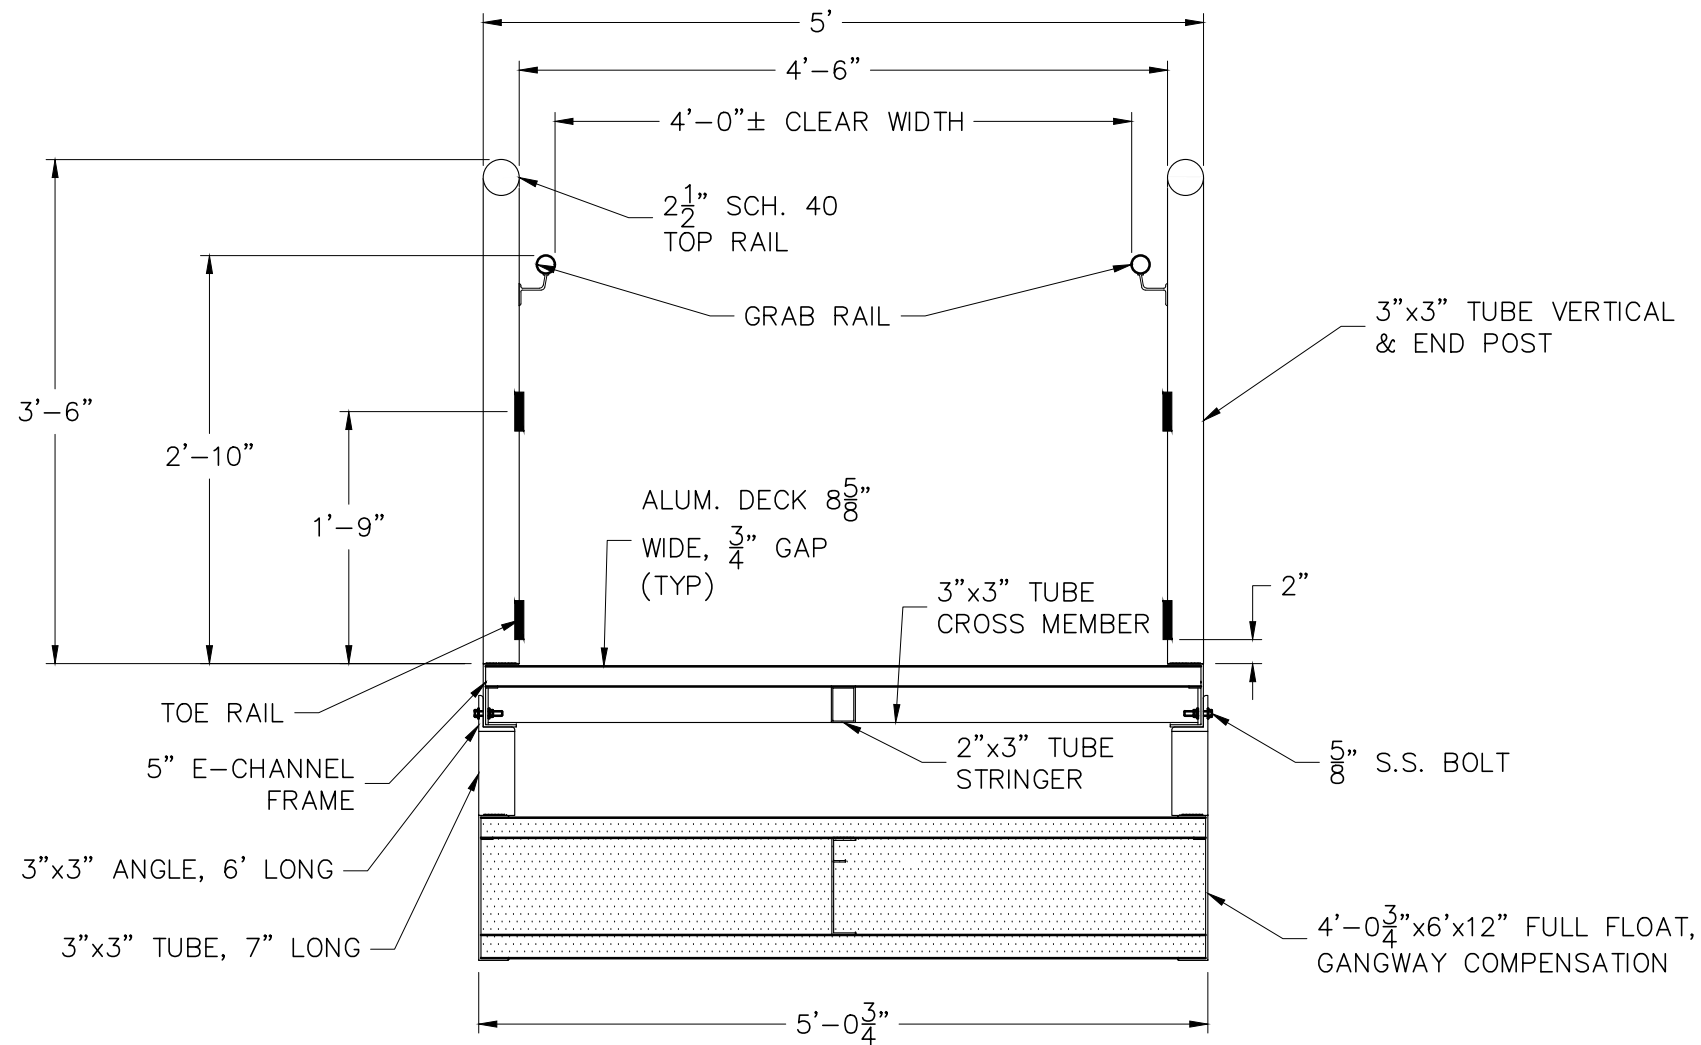

GANGWAY SECTION

SCALE: $\frac{3}{4}$ "=1'-0"

* $\frac{3}{4}$ " GAP FOR DECKING PER CLIENT'S REQUEST (GANGWAY ONLY)



2880 MELLONVILLE AVE, SANFORD, FL 32773

800/256-8857 407/323-0190

THE INFORMATION CONTAINED IN THIS DRAWING IS THE SOLE PROPERTY OF GATOR DOCK & MARINE, LLC. ANY REPRODUCTION IN PART OR AS A WHOLE WITHOUT THE WRITTEN PERMISSION OF GATOR DOCK & MARINE, LLC IS PROHIBITED.

RECORD OF REVISIONS		
No.	DATE	DESCRIPTION:
0	7/20/18	DRAFT
1	7/26/18	DRAFT
2	7/30/18	AS BUILT

PROJECT NAME:

WOODLAND WHARF

CUSTOMER NAME:

DELAWARE DNREC

CUSTOMER ADDRESS:

89 KINGS HIGHWAY
DOVER, DE 19901

PROJECT LOCATION:

5115 WOODLAND FERRY RD
SEAFORD, DE 19973

CMI ORDER NO.:

N/A

CUST. PO NO.:

N/A

	NAME	DATE
DRAWN BY:	VRP	7/30/18
CHECKED BY:	JN	7/24/18

DRAWING NO.:

S-302

GANGWAY PLAN


SHEET: 3 of 8

Physical properties are defined by ASTM testing standards, The Aluminum Association Design Manual, and/or standard engineering practice. The values shown are nominal and may vary. The information found in this document is believed to be true and accurate. No warranties of any kind are made as to the suitability of any CMI product for particular applications or the results obtained there from. ShoreGuard, C-Loc, TimberGuard, GeoGuard, Dura Dock, Shore-All, and Gator Gates are registered trademarks of CMI Limited Co. ArmorWare, Ultra Composite, GatorDocks, and CMI Waterfront Solutions are trademarks of CMI Limited Co. United States and International numbers 5,145,287; 5,881,508; 6,000,883; 6,033,155; 6,053,666; D420,154; 4,674,921; 4,690,588; 5,292,208; 6,575,667; 7,059,807; 7,056,066; 7,025,539; 1,245,061; c Other patents pending. 2017 CMI Limited Co. All Rights Reserved.

CMI LIMITED CO.


1165 NORTHCHASE PARKWAY SE
SUITE 300 - MARIETTA, GA 30067
PHONE: 770-933-8166

NOT FOR CONSTRUCTION

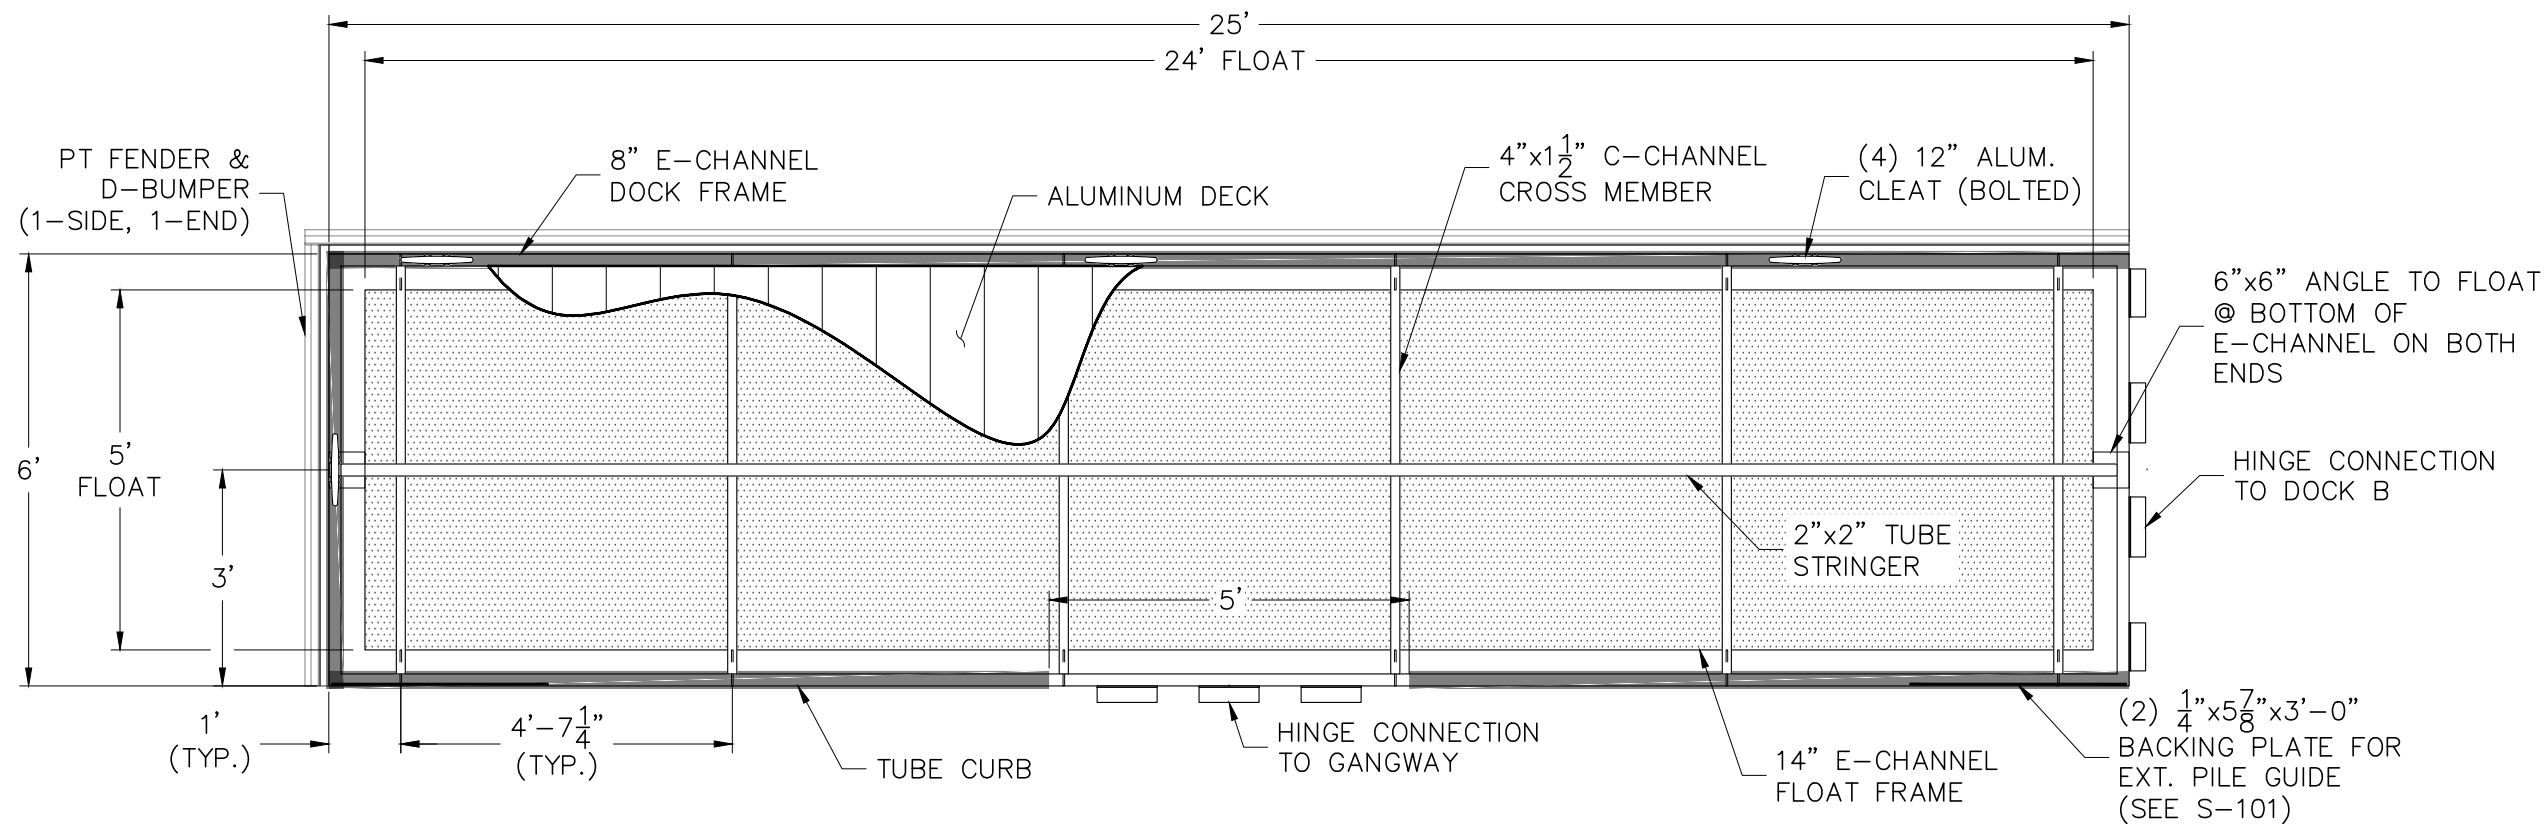

DOCK A PLAN
SCALE: 3/8"=1'-0"

WEIGHT ≈ 2,200 lbs

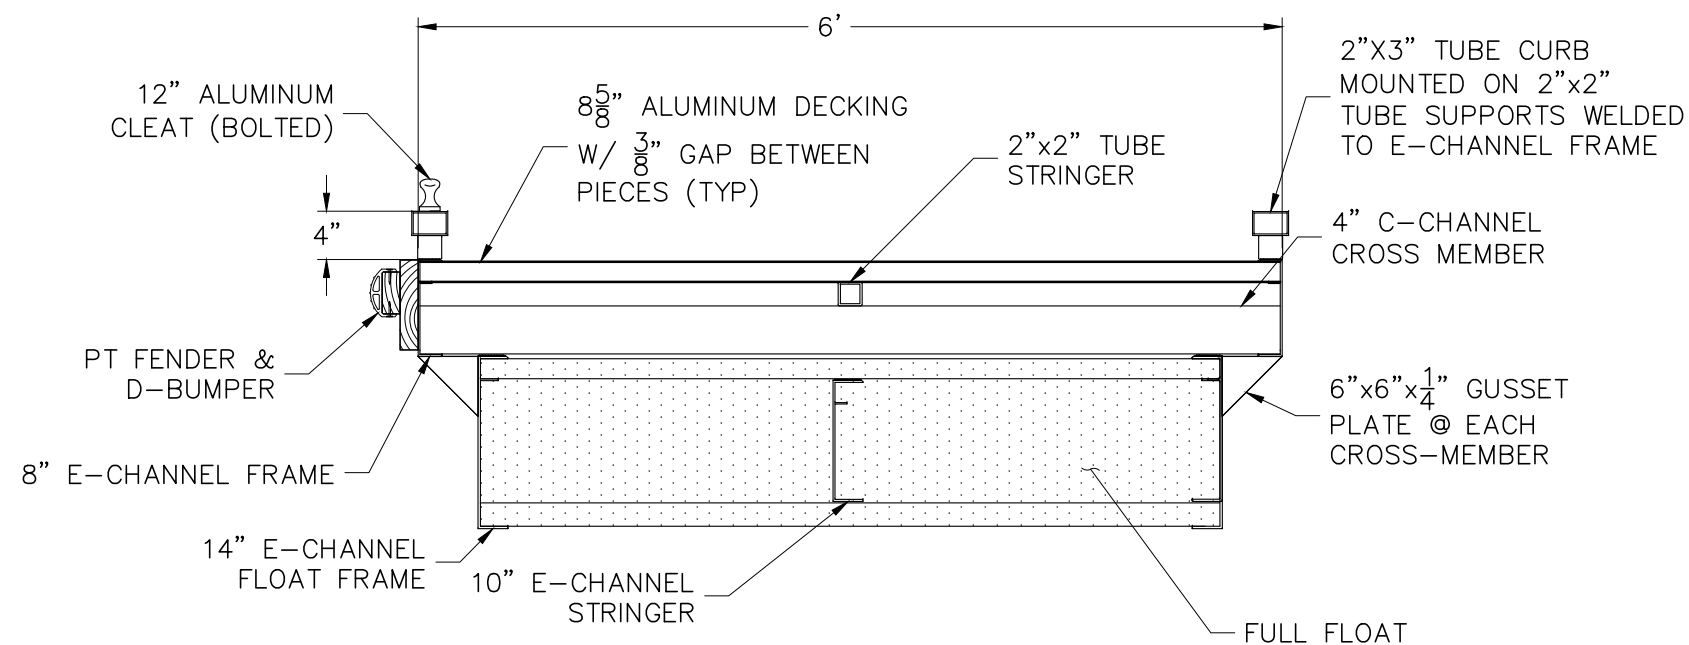

DOCK SECTION
SCALE: 3/4"=1'-0"



2880 MELLONVILLE AVE, SANFORD, FL 32773
800/256-8857 407/323-0190

THE INFORMATION CONTAINED IN THIS DRAWING IS THE SOLE PROPERTY OF GATOR DOCK & MARINE, LLC. ANY REPRODUCTION IN PART OR AS A WHOLE WITHOUT THE WRITTEN PERMISSION OF GATOR DOCK & MARINE, LLC IS PROHIBITED.

RECORD OF REVISIONS

No.	DATE	DESCRIPTION:
0	7/20/18	DRAFT
1	7/26/18	DRAFT
2	7/30/18	AS BUILT

PROJECT NAME:

WOODLAND WHARF

CUSTOMER NAME:

DELAWARE DNREC

CUSTOMER ADDRESS:

**89 KINGS HIGHWAY
DOVER, DE 19901**

PROJECT LOCATION:

**5115 WOODLAND FERRY RD
SEAFORD, DE 19973**

CMI ORDER NO.:

N/A

CUST. PO NO.:

N/A

	NAME	DATE
--	------	------

DRAWN BY: VRP 7/30/18

CHECKED BY: JN 7/24/18

DRAWING NO.:


S-401

DOCK PLAN


SHEET: 4 of 8

Physical properties are defined by ASTM testing standards. The Aluminum Association Design Manual, and/or standard engineering practice. The values shown are nominal and may vary. The information found in this document is believed to be true and accurate. No warranties of any kind are made as to the suitability of any CMI product for particular applications or the results obtained there from. ShoreGuard, C-Loc, TimberGuard, GeoGuard, Dura Dock, Shore-All, and Gator Gates are registered trademarks of CMI Limited Co. ArmorWare, Ultra Composite, GatorDocks, and CMI Waterfront Solutions are trademarks of CMI Limited Co. United States and International numbers 5,145,287; 5,881,508; 6,000,883; 6,033,155; 6,053,666; D420,154; 4,674,921; 4,690,588; 5,292,208; 6,575,667; 7,059,807; 7,056,066; 7,025,539; 1,245,061; c Other patents pending. 2017 CMI Limited Co. All Rights Reserved.

CMI LIMITED CO.
1165 NORTHCHASE PARKWAY SE
SUITE 300 - MARIETTA, GA 30067
PHONE: 770-933-8166

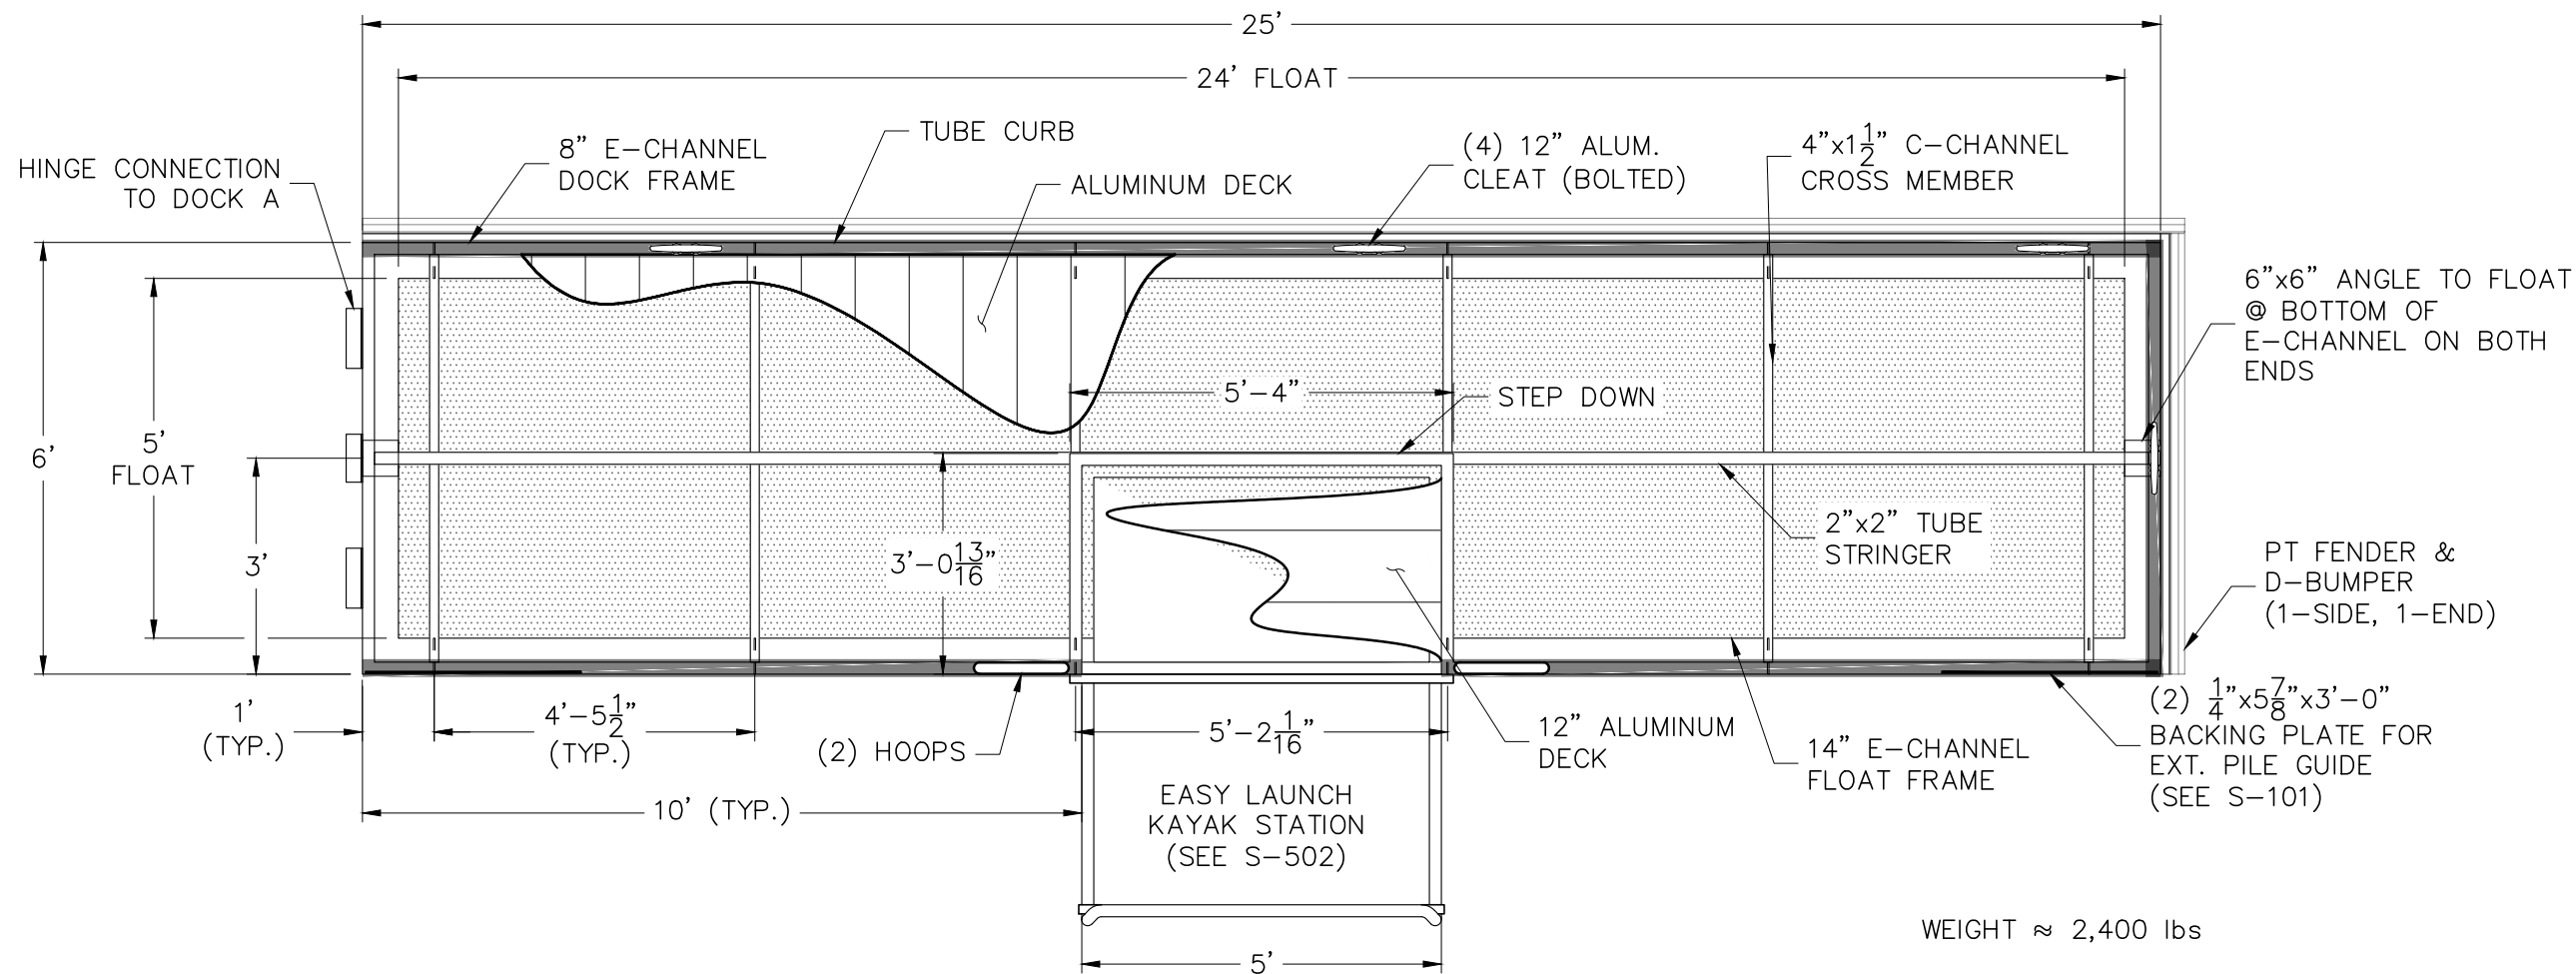

DOCK B PLAN
SCALE: 3/8"=1'-0"

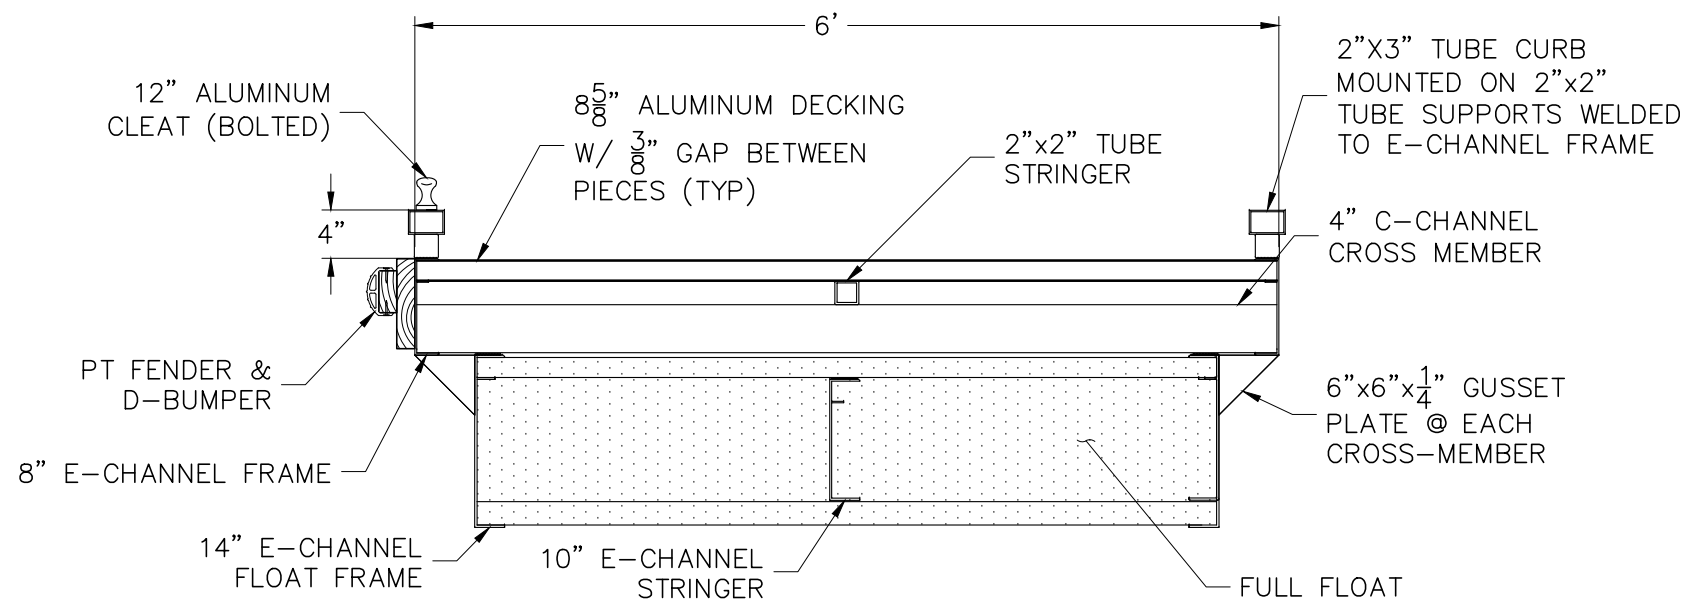

DOCK SECTION
SCALE: 3/4"=1'-0"



2880 MELLONVILLE AVE, SANFORD, FL 32773
800/256-8857 407/323-0190

THE INFORMATION CONTAINED IN THIS DRAWING IS THE SOLE PROPERTY OF GATOR DOCK & MARINE, LLC. ANY REPRODUCTION IN PART OR AS A WHOLE WITHOUT THE WRITTEN PERMISSION OF GATOR DOCK & MARINE, LLC IS PROHIBITED.

RECORD OF REVISIONS

No.	DATE	DESCRIPTION:
0	7/20/18	DRAFT
1	7/26/18	DRAFT
2	7/30/18	AS BUILT

PROJECT NAME:

WOODLAND WHARF

CUSTOMER NAME:

DELAWARE DNREC

CUSTOMER ADDRESS:

89 KINGS HIGHWAY
DOVER, DE 19901

PROJECT LOCATION:

5115 WOODLAND FERRY RD
SEAFORD, DE 19973

CMI ORDER NO.:

N/A

CUST. PO NO.:

N/A

NAME DATE

DRAWN BY: VRP 7/30/18

CHECKED BY: JN 7/24/18

DRAWING NO.:











S-402

DOCK PLAN


SHEET: 5 of 8

Physical properties are defined by ASTM testing standards. The Aluminum Association Design Manual, and/or standard engineering practice. The values shown are nominal and may vary. The information found in this document is believed to be true and accurate. No warranties of any kind are made as to the suitability of any CMI product for particular applications or the results obtained there from. ShoreGuard, C-Loc, TimberGuard, GeoGuard, Dura Dock, Shore-All, and Gator Gates are registered trademarks of CMI Limited Co. ArmorWare, Ultra Composite, GatorDocks, and CMI Waterfront Solutions are trademarks of CMI Limited Co. United States and International numbers 5,145,287; 5,881,508; 6,000,883; 6,033,155; 6,053,666; D420,154; 4,674,921; 4,690,588; 5,292,208; 6,575,667; 7,059,807; 7,056,066; 7,025,539; 1,245,061; c Other patents pending. 2017 CMI Limited Co. All Rights Reserved.









CMI LIMITED CO.
1165 NORTHCHASE PARKWAY SE
SUITE 300 - MARIETTA, GA 30067
PHONE: 770-933-8166

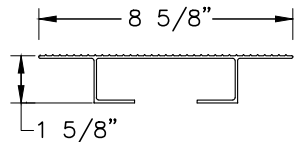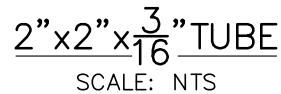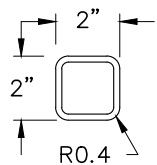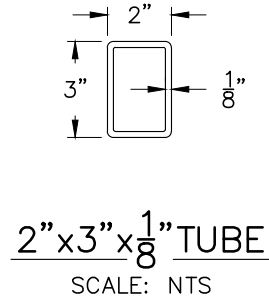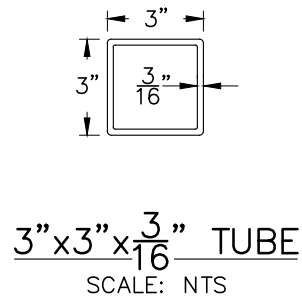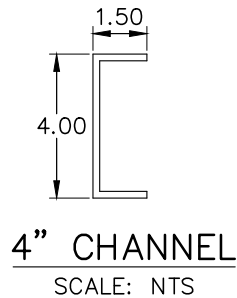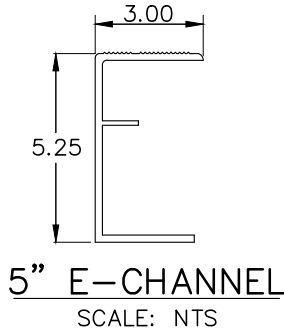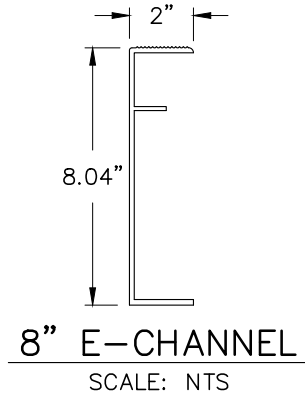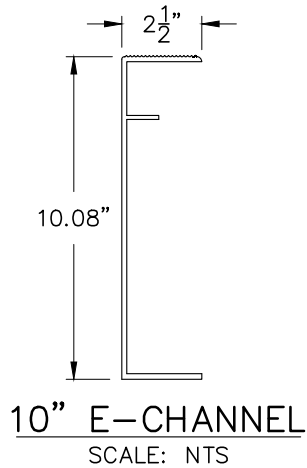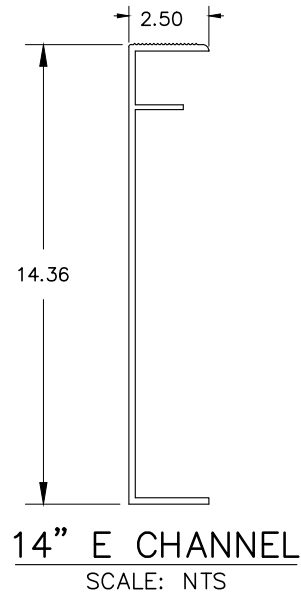

* LIGHT KNURL TO RUN PERPENDICULAR TO RIBS.

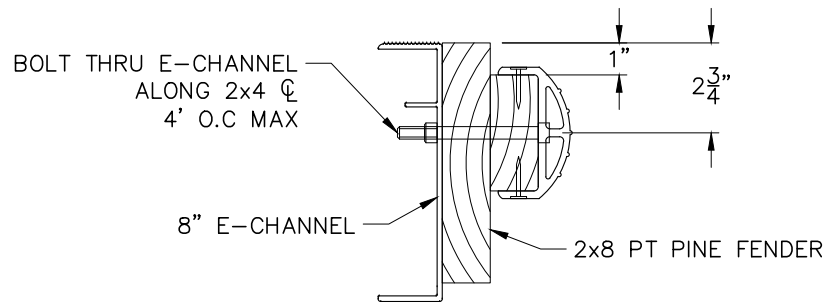

VINYL D-BUMPER
SCALE: NTS
(COLOR: WHITE)

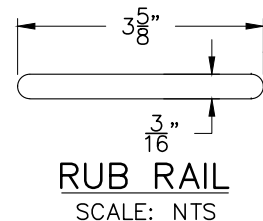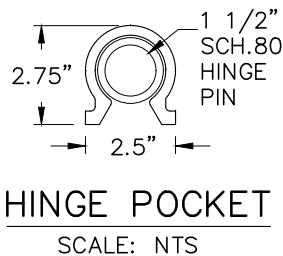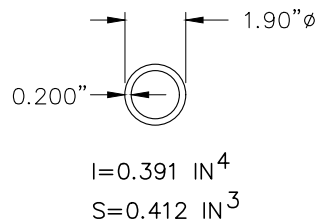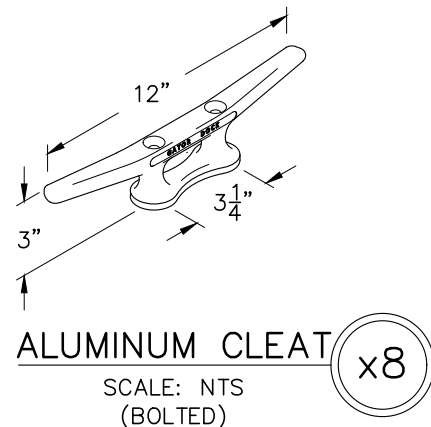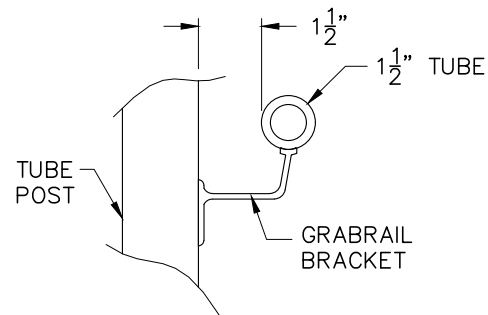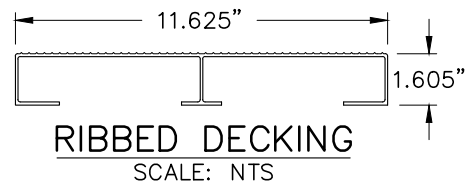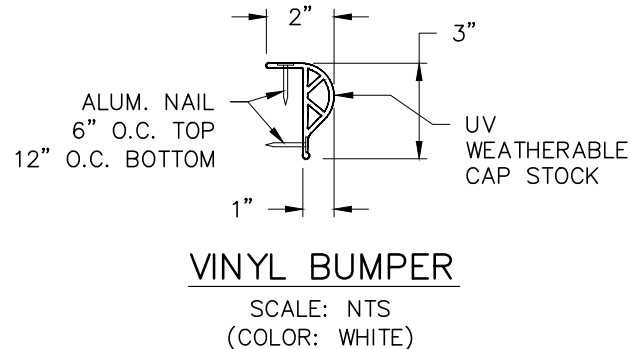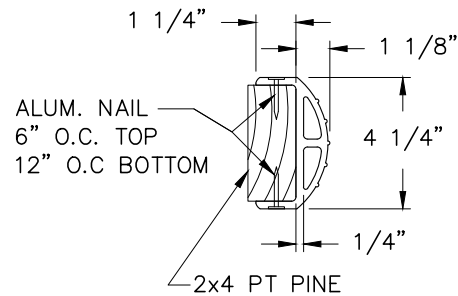

GatorDock
Marine Access Solutions

2880 MELLONVILLE AVE, SANFORD, FL 32773
800/256-8857 407/323-0190

THE INFORMATION CONTAINED IN THIS DRAWING IS THE SOLE PROPERTY OF GATOR DOCK & MARINE, LLC. ANY REPRODUCTION IN PART OR AS A WHOLE WITHOUT THE WRITTEN PERMISSION OF GATOR DOCK & MARINE, LLC IS PROHIBITED.

RECORD OF REVISIONS		
No.	DATE	DESCRIPTION:
0	7/20/18	DRAFT
1	7/26/18	DRAFT
2	7/30/18	AS BUILT

PROJECT NAME:
WOODLAND WHARF

CUSTOMER NAME:
DELAWARE DNREC

CUSTOMER ADDRESS:
**89 KINGS HIGHWAY
DOVER, DE 19901**

PROJECT LOCATION:
**5115 WOODLAND FERRY RD
SEAFORD, DE 19973**

CMI ORDER NO.:
N/A

CUST. PO NO.:
N/A

	NAME	DATE
DRAWN BY:	VRP	7/30/18
CHECKED BY:	JN	7/24/18

DRAWING NO.:
S-501
COMPONENT DETAILS




SHEET: 6 of 8

Physical properties are defined by ASTM testing standards. The Aluminum Association Design Manual, and/or standard engineering practice. The values shown are nominal and may vary. The information found in this document is believed to be true and accurate. No warranties of any kind are made as to the suitability of any CMI product for particular applications or the results obtained there from. ShoreGuard, C-Lox, TimberGuard, GeoGuard, Dura Dock, Shore-All, and Gator Gates are registered trademarks of CMI Limited Co. ArmorWare, Ultra Composite, GatorDocks, and CMI Waterfront Solutions are trademarks of CMI Limited Co. United States and International numbers 5,145,287; 5,881,508; 6,000,883; 6,033,155; 6,053,666; D420,154; 4,674,921; 4,690,588; 5,292,208; 6,575,667; 7,059,807; 7,056,066; 7,025,539; 1,245,061; c Other patents pending. 2017 CMI Limited Co. All Rights Reserved.

CMI LIMITED CO.
1165 NORTHCHASE PARKWAY SE
SUITE 300 - MARIETTA, GA 30067
PHONE: 770-933-8166

NOT FOR CONSTRUCTION



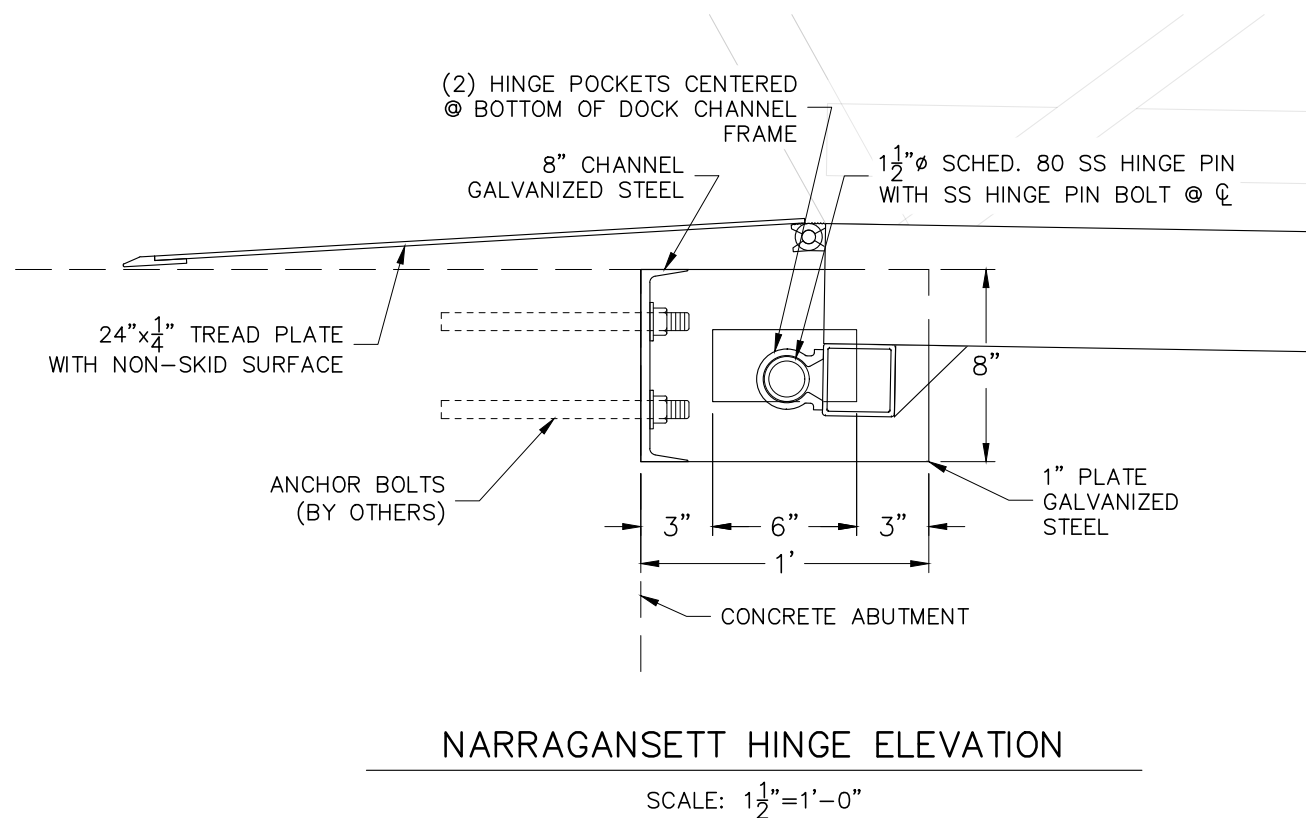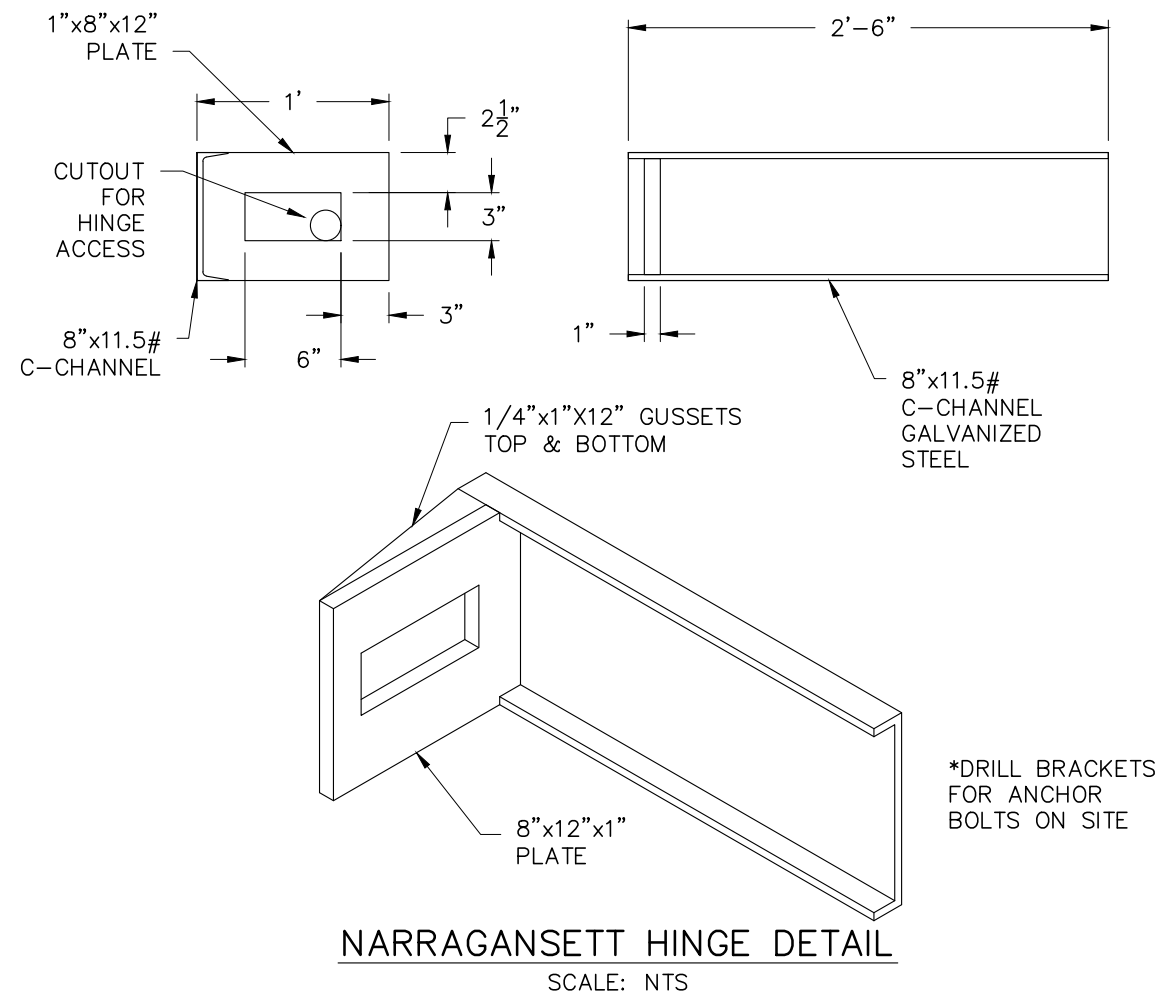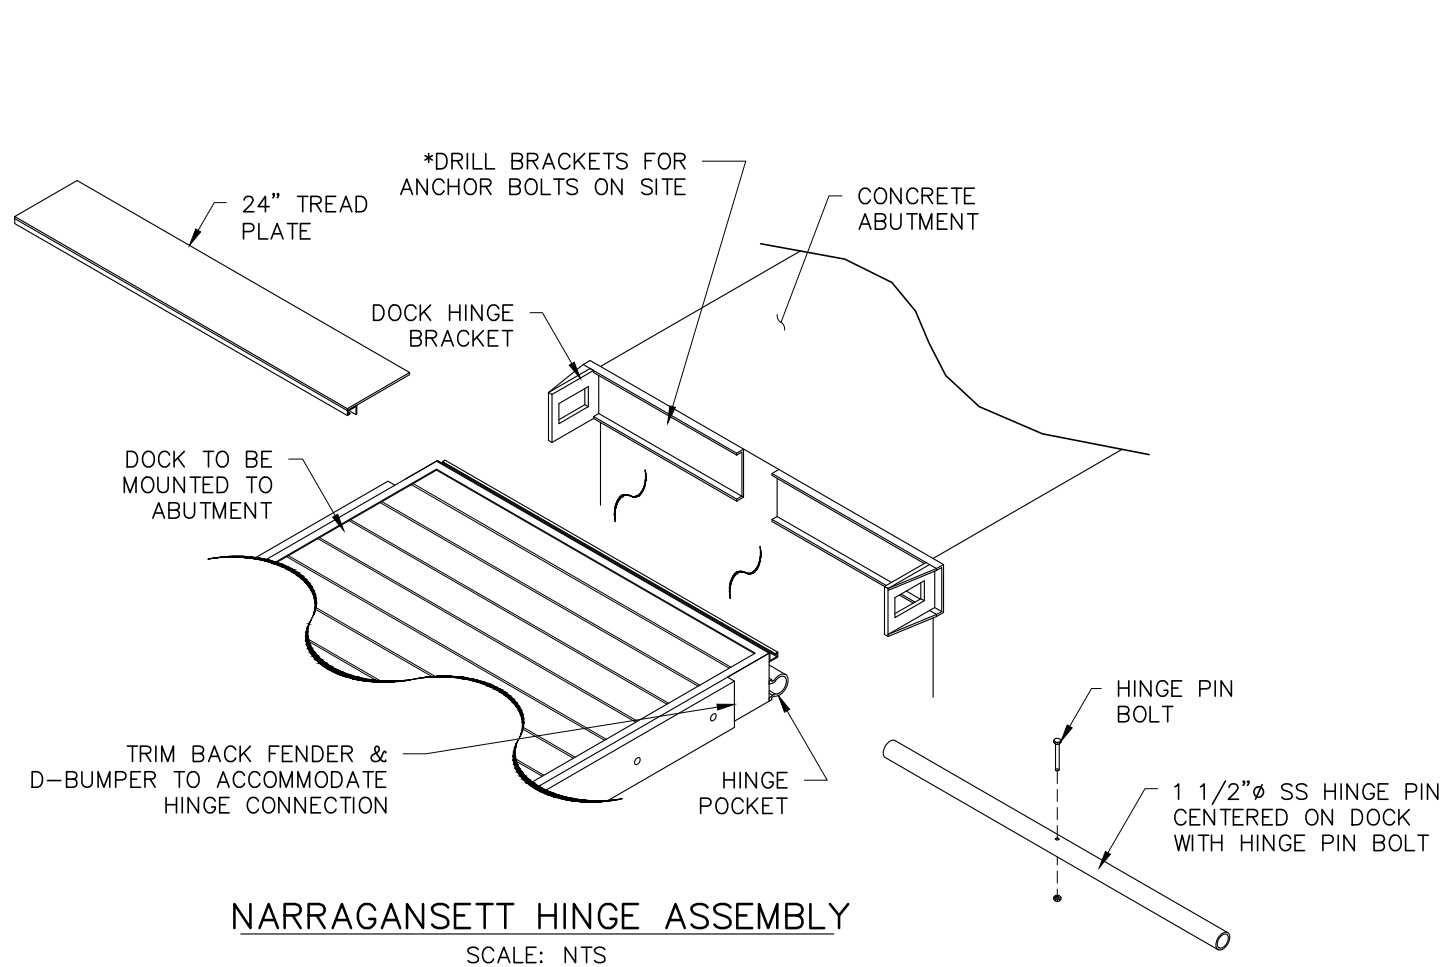

RECORD OF REVISIONS

No.	DATE	DESCRIPTION:
0	7/20/18	DRAFT
1	7/26/18	DRAFT
2	7/30/18	AS BUILT

PROJECT NAME:

WOODLAND WHARF

CUSTOMER NAME:

DELAWARE DNREC

CUSTOMER ADDRESS:

89 KINGS HIGHWAY
DOVER, DE 19901

PROJECT LOCATION:

5115 WOODLAND FERRY RD
SEAFORD, DE 19973

CMI ORDER NO.:

N/A

CUST. PO NO.:

N/A

	NAME	DATE
DRAWN BY:	VRP	7/30/18
CHECKED BY:	JN	7/24/18

DRAWING NO.:

S-503

COMPONENT DETAILS

SHEET: 8 of 8

Physical properties are defined by ASTM testing standards. The Aluminum Association Design Manual, and/or standard engineering practice. The values shown are nominal and may vary. The information found in this document is believed to be true and accurate. No warranties of any kind are made as to the suitability of any CMI product for particular applications or the results obtained there from. ShoreGuard, C-Loc, TimberGuard, GeoGuard, Dura Dock, Shore-All, and Gator Gates are registered trademarks of CMI Limited Co. ArmorWare, Ultra Composite, GatorDocks, and CMI Waterfront Solutions are trademarks of CMI Limited Co. United States and International numbers 5,145,287; 5,881,508; 6,000,883; 6,033,155; 6,053,666; D420,154; 4,674,921; 4,690,588; 5,292,208; 6,575,667; 7,059,807; 7,056,066; 7,025,539; 1,245,061; c Other patents pending. 2017 CMI Limited Co. All Rights Reserved.

CMI LIMITED CO.
1165 NORTHCHASE PARKWAY SE
SUITE 300 - MARIETTA, GA 30067
PHONE: 770-933-8166